



FÖRKLARINGAR
 ——— BRANDCELLSGRÄNS EI-60
 - - - - - BRANDCELLSGRÄNS EI-30

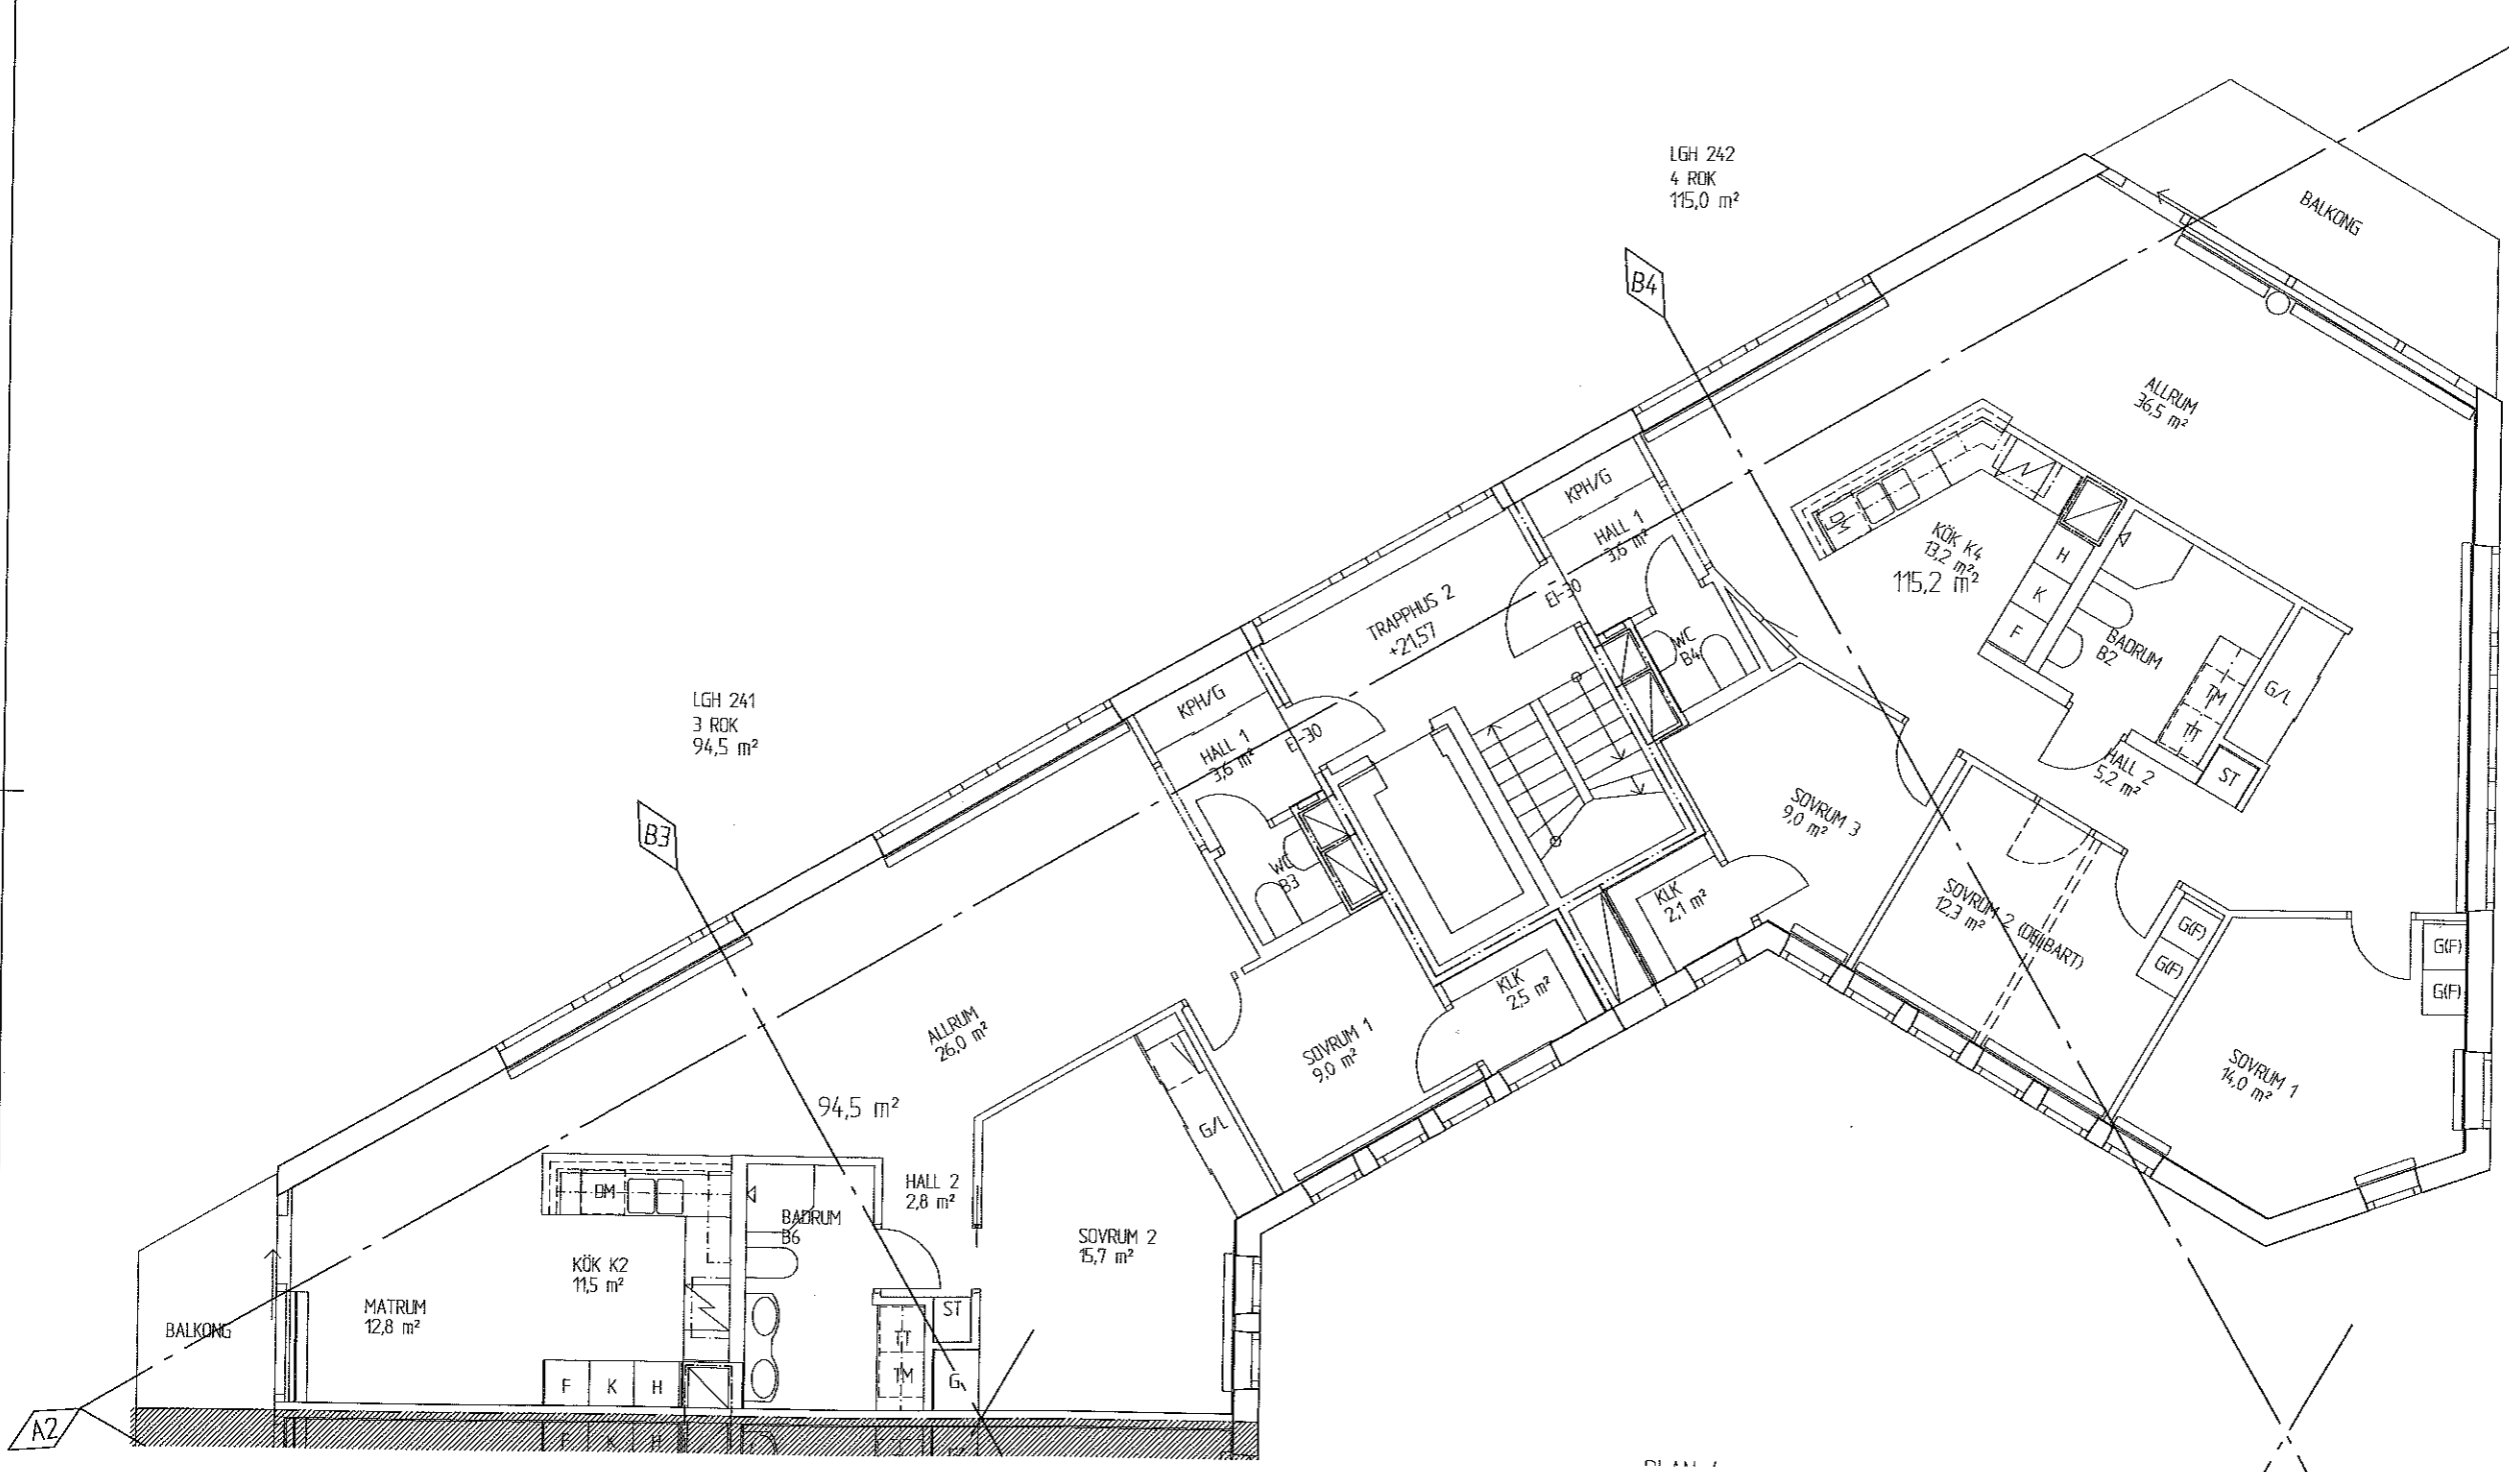

LGH 242
 4 ROK
 115,0 m²

LGH 241
 3 ROK
 94,5 m²

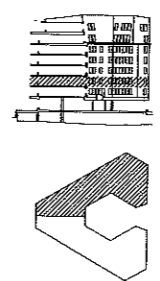

RELATIONSHANDLING

REV	ANT	ÄNDRING	ORSAK	DATEM

A		RELATIONSHANDLING	PED	2003-01-21
169 82 Stockholm		Telegrafgatan 4, Solna	Tel 08-782 87 00	
<input type="checkbox"/> A Nyréns Arkitektkontor 08-698 43 00 <input checked="" type="checkbox"/> A M AB 08-782 87 00 <input type="checkbox"/> K SLB AB 08-706 45 50 <input type="checkbox"/> Y Metator VVS Konsult AB 08-702 32 50 <input type="checkbox"/> E Ee Kalkyl AB 016-48 15 90 <input type="checkbox"/> L Nyréns Arkitektkontor 08-698 43 00		KULLTORP		
RITAD KONSTRUKTIONSD PED		HANDLINGSKÄRNE	ARBETSNUMMER	
DATUM	ANVÄNDIG	KOD TYP POS	RITINGSNUMMER	
2001-11-26			A3 1:100 A1 1:50	
			A30:204	A

2003-2-21 9:25 D:\Projekt\KULLTORP\RELATIONSHANDLINGAR\A30-204.dwg