


FÖRKLARINGAR

- BRANDELLSGRÄNS EI-60
- BRANDELLSGRÄNS EI-30

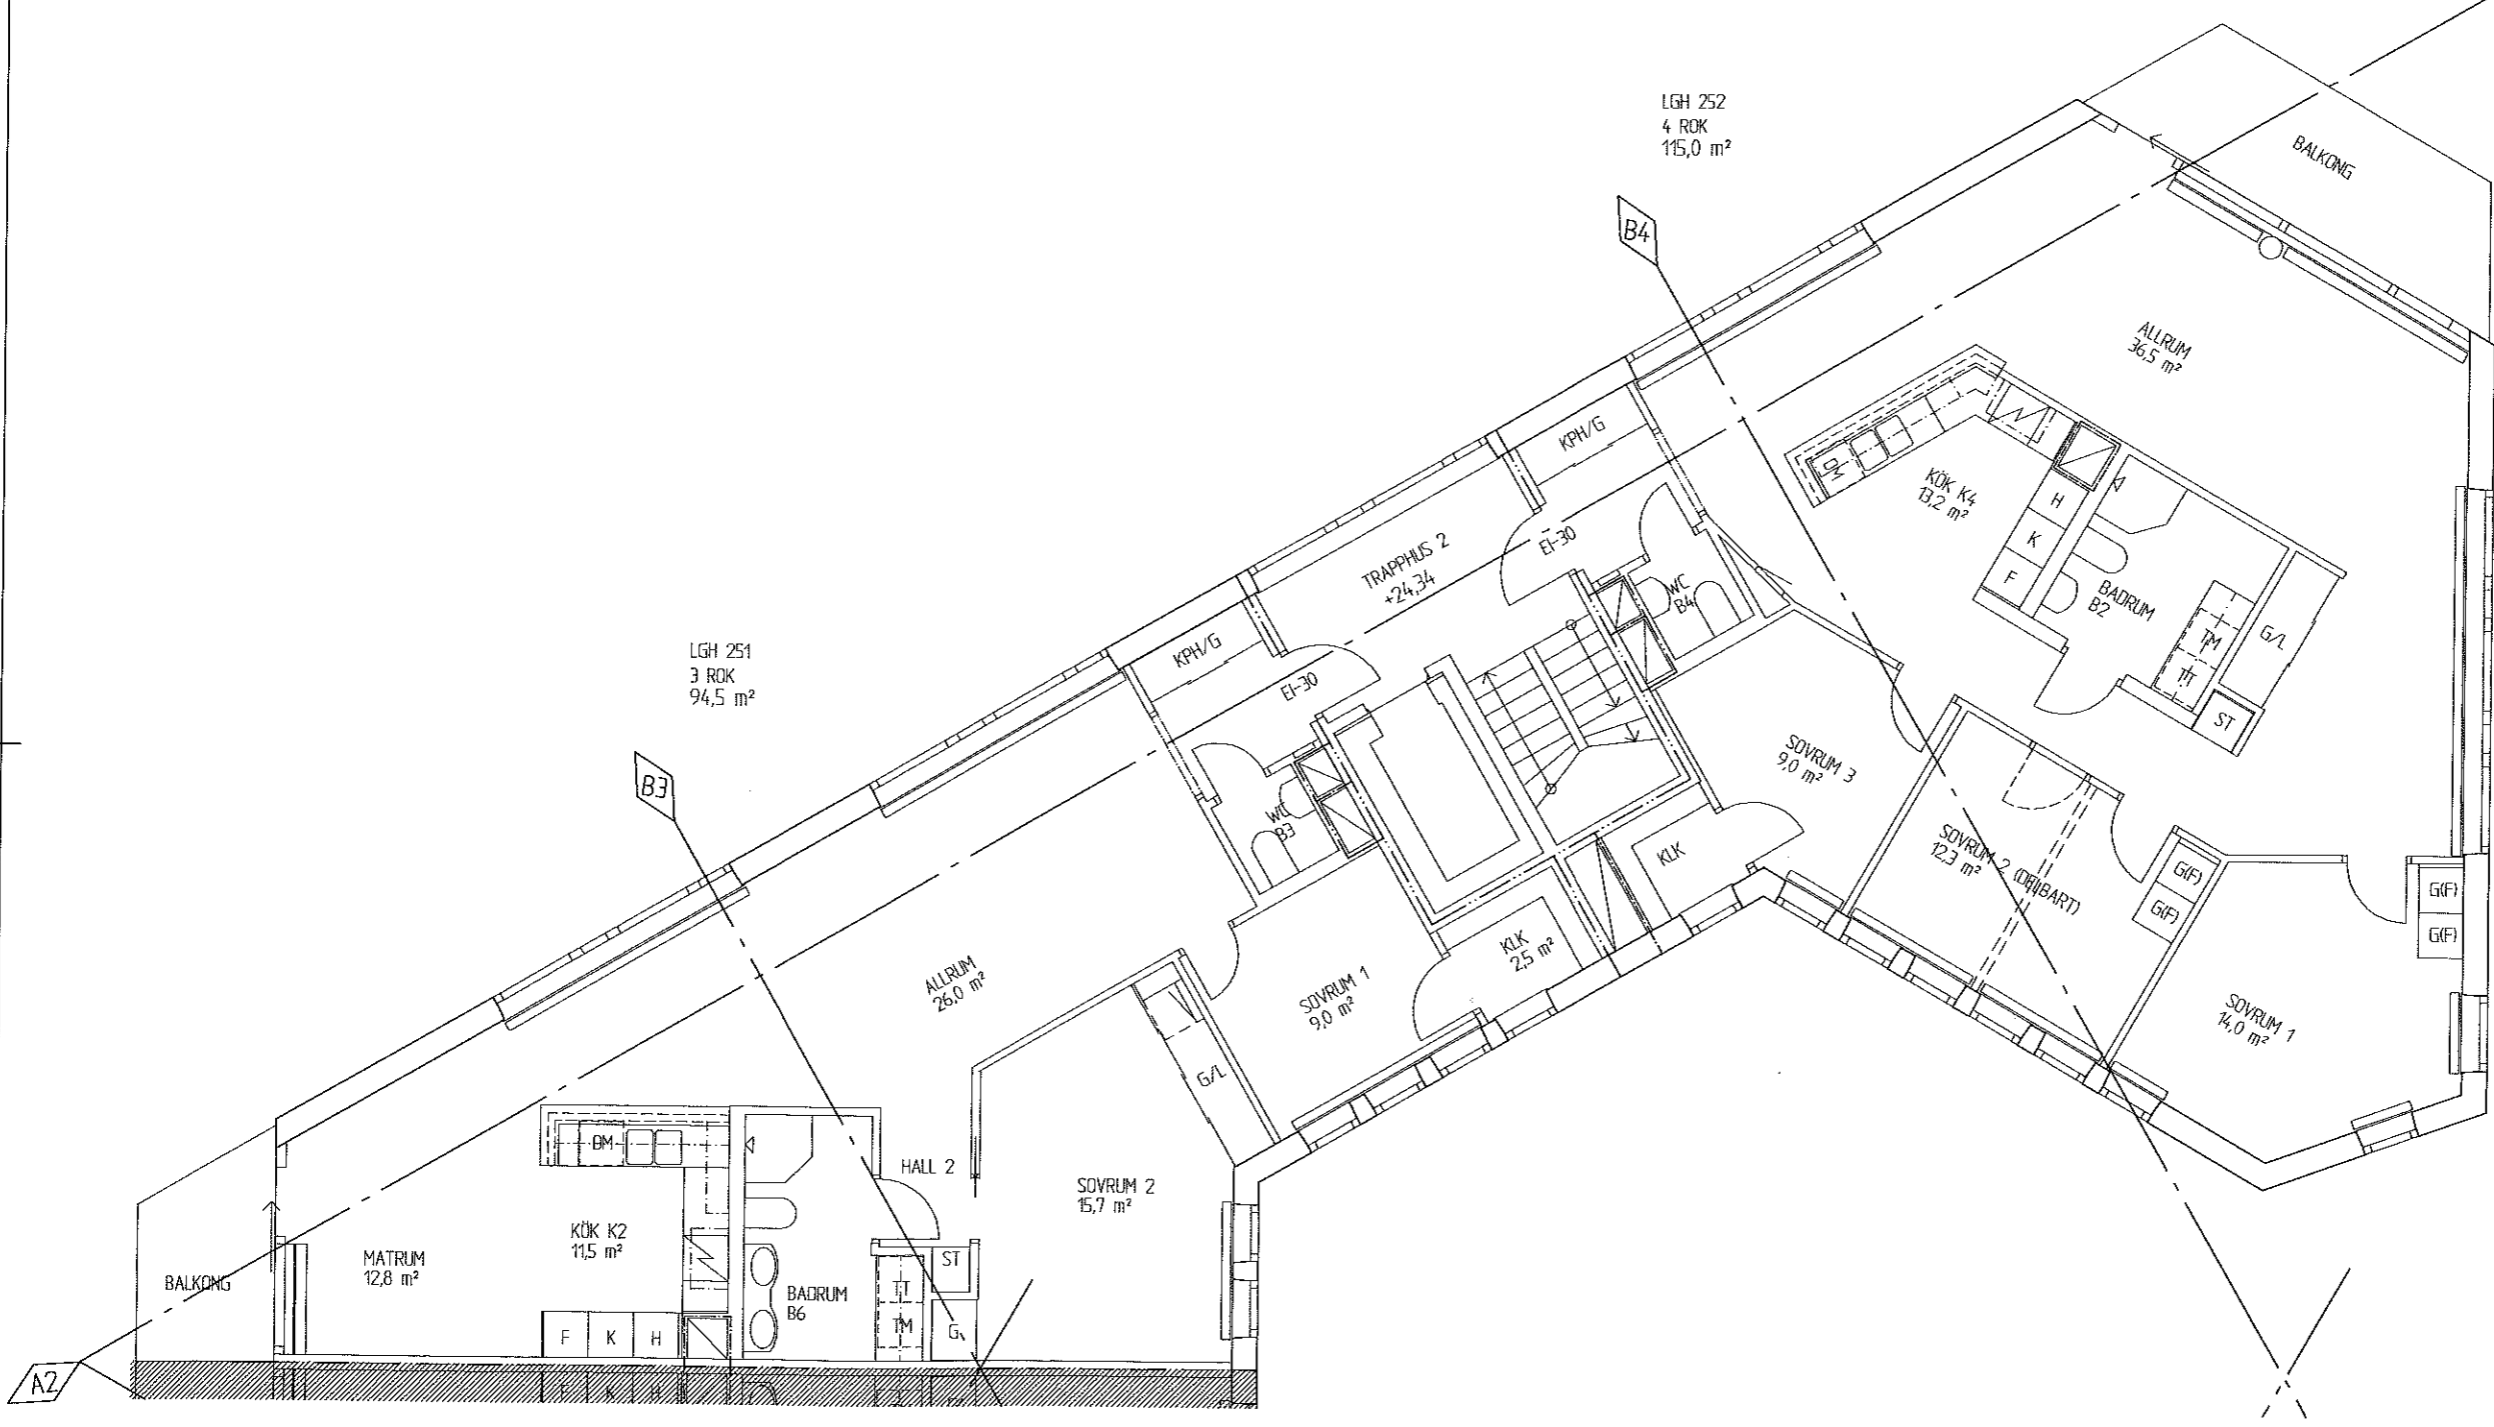

LGH 252
4 ROK
115,0 m²

LGH 251
3 ROK
94,5 m²

ALLRUM
26,0 m²

SOVRUM 2
15,7 m²

SOVRUM 1
9,0 m²

KLK
2,5 m²

SOVRUM 3
9,0 m²

SOVRUM 2 (DVBART)
12,3 m²

SOVRUM 1
14,0 m²

ALLRUM
36,5 m²

KÖK K4
13,2 m²

BADRUM
B2

TRAPPHUS 2
+24,34

KPH/G

EI-30

WC
B3

WC
B4

HALL 2

KÖK K2
11,5 m²

BADRUM
B6

MATRUM
12,8 m²

BALKONG

RELATIONSHANDLING

A	RELATIONSHANDLING	PED	2003-01-21
REV	ANT	ÄNDNINGEN ANVÄR	SKEN

169 82 Stockholm
Telegrafgatan 4, Solna
Tel 08-782 87 00

KULLTORP

TRAPPHUS 2, PLAN 5

- A Nyréns Arkitektkontor 08-698 43 00
- A JM AB 08-782 87 00
- K SLB AB 08-706 45 50
- V Metator VVS Konsult AB 08-702 32 50
- E Ee Kalkyl AB 016-45 15 90
- L Nyréns Arkitektkontor 08-698 43 00

REDA KONSTRUKTOR	HANDLAGGARE	ARBETSNUMMER
PED		
DATAN	ANSVARS	
2001-11-26		

KOD TYP	PCB	REVISOR	SKALA	A3	1:100
			A1	A1	1:50
					REV
					A