


FÖRKLARINGAR

- BRANDCELLSGRÄNS EI-60
- - - BRANDCELLSGRÄNS EI-30

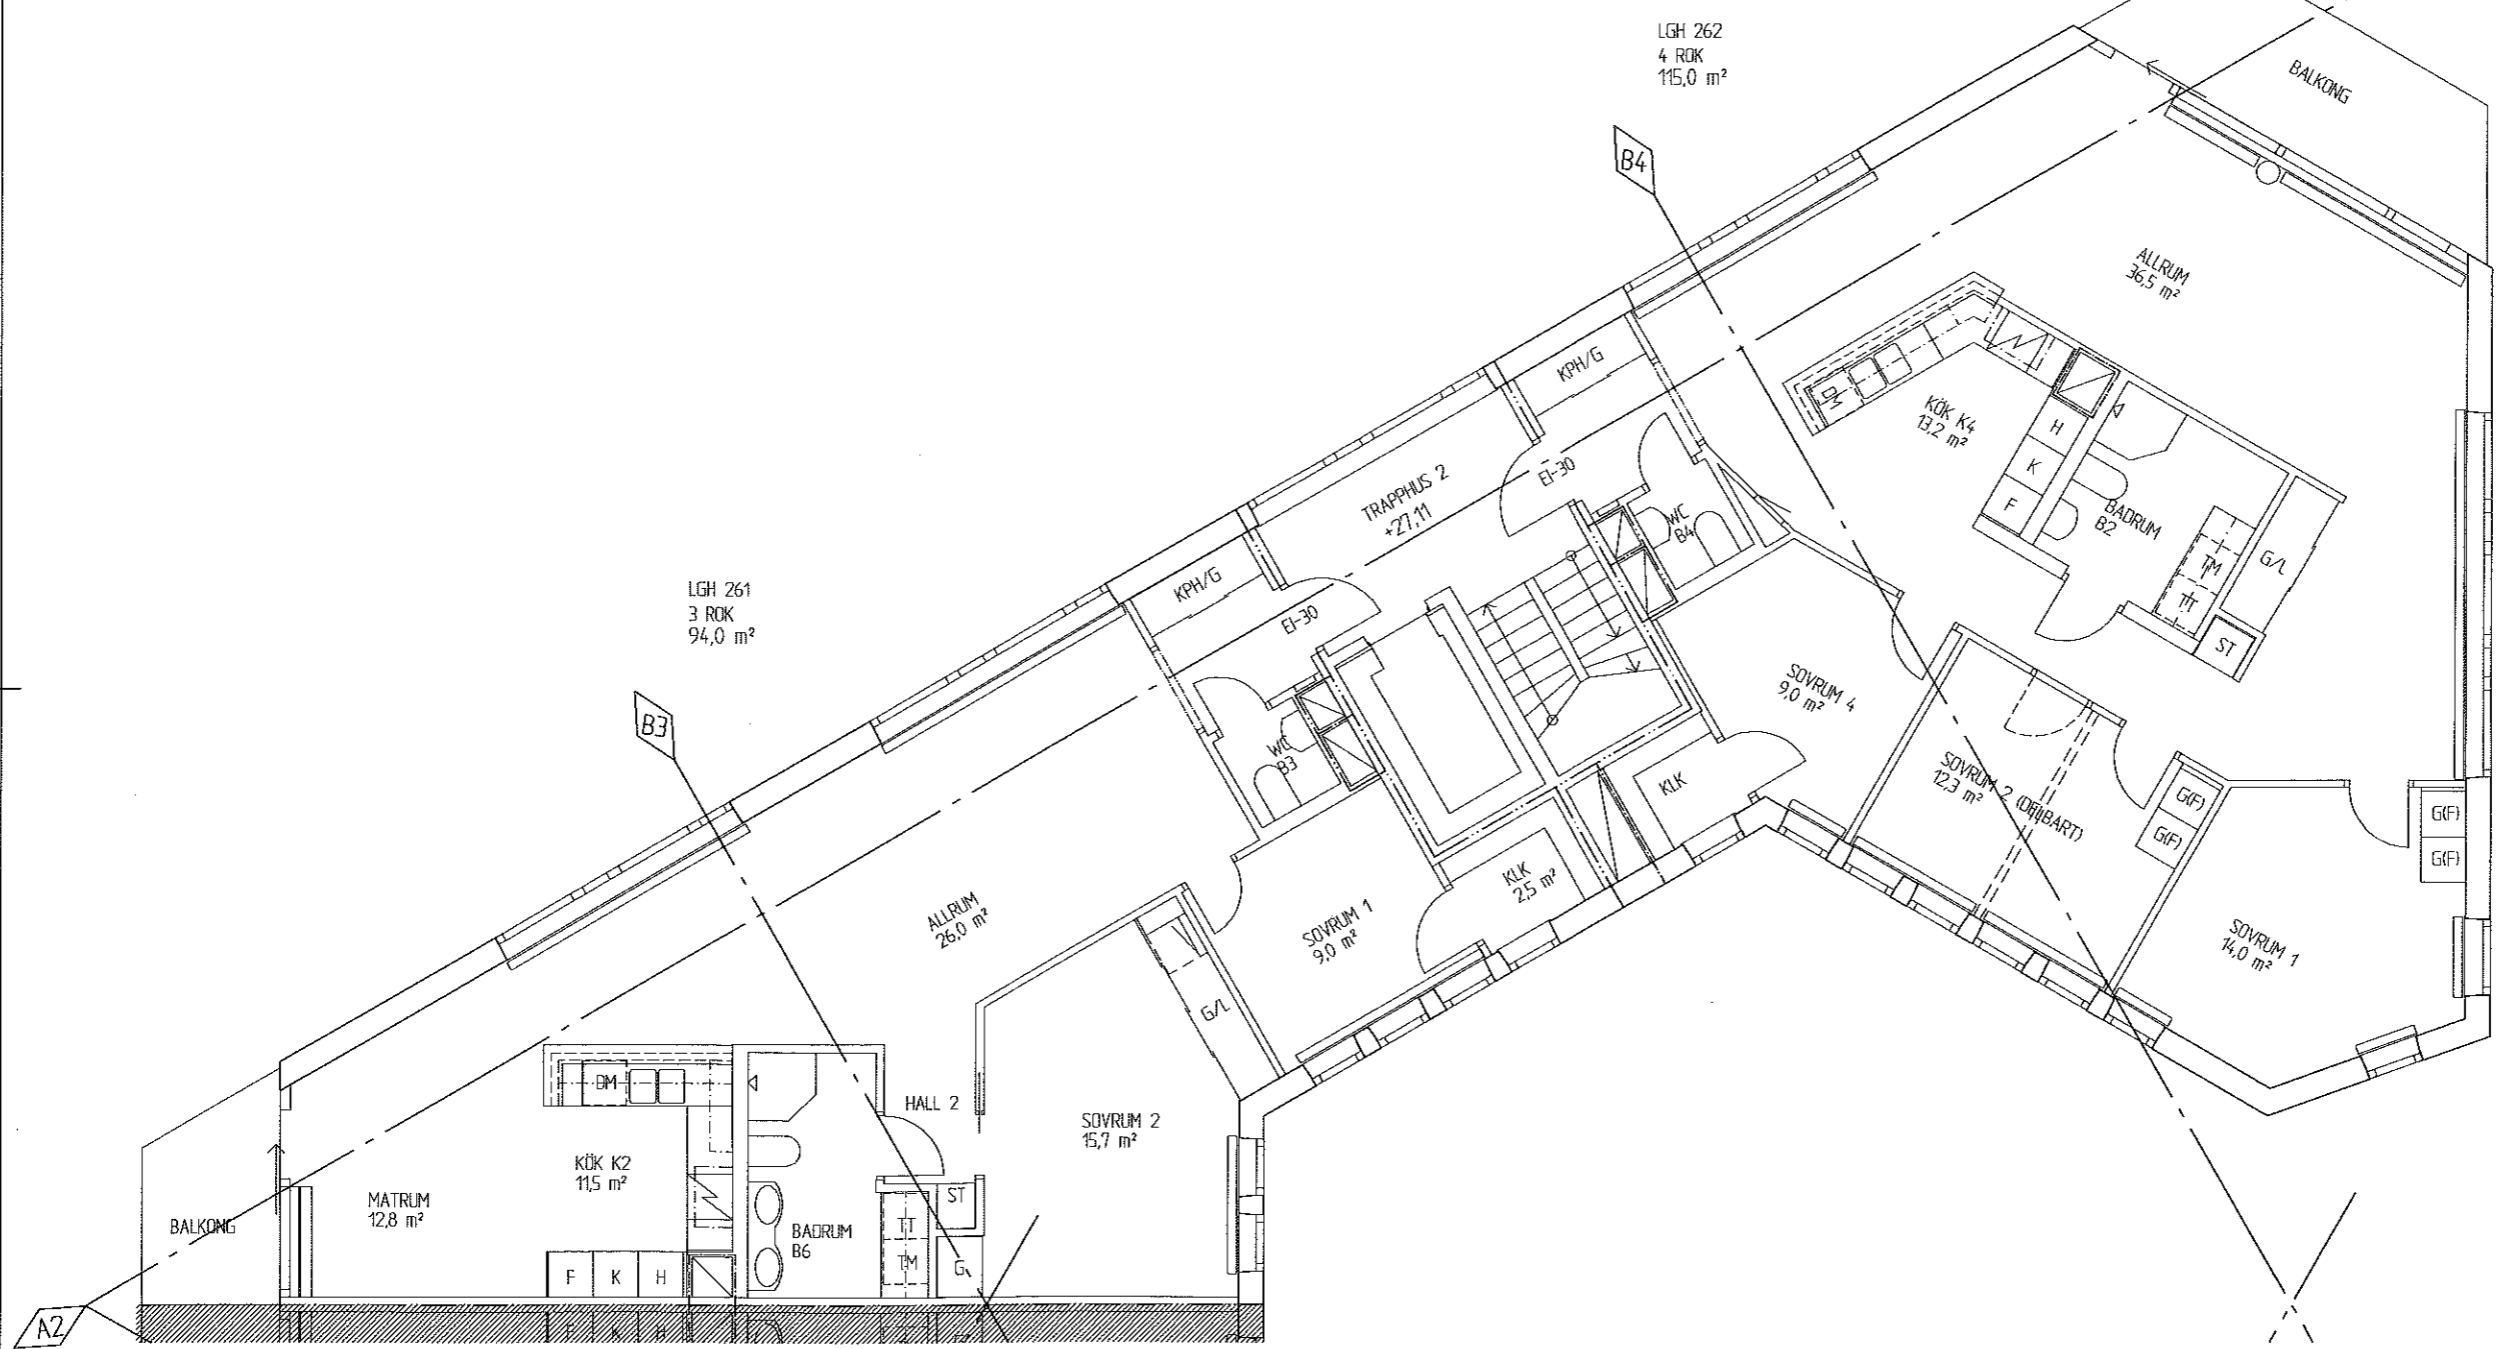

LGH 262  
4 ROK  
115,0 m²

LGH 261  
3 ROK  
94,0 m²

RELATIONSHANDLING

A	RELATIONSHANDLING	PED	2003-01-21
REF	ART	ANMÄRKNING	SKEN

169 82 Stockholm  
Telegrafgatan 4, Solna Tel 08-782 87 00

<input type="checkbox"/> A Nyréns Arkitektkontor 08-698 43 00 <input checked="" type="checkbox"/> A JM AB 08-782 87 00 <input type="checkbox"/> K SLB AB 08-706 45 50 <input type="checkbox"/> V Melator VVS Konsult AB 08-702 32 50 <input type="checkbox"/> E Ee Kalkyl AB 016-48 15 90 <input type="checkbox"/> L Nyréns Arkitektkontor 08-698 43 00		KULLTORP TRAPPHUS 2, PLAN 6 A3 1:100 A1 1:50
RITAD KONSTRUKTOR PED	HANDELAGGARE ANMÄRKNING	ARBETSNUMMER DATUM 2001-11-26
RITNINGSNUMMER A30.206	REV A	RITNINGSTYP A

